
REVISIONS						
REV.	ECO	DATE	DESCRIPTION	AUTH.	DR.	ZONE
7	SI1782	10/08/2021	ADDED U-BOLT, ENCLOSURE & TANK CALLOUTS,AMPS COLUMN & FLOW DIRECTION. UPDATED KNOCKOUT SIZE, INLET & OUTLET CALLOUTS, ELEMENT REPLACEMENT DIM. & WIRING SCHEMATIC. REMOVED REPLACEMENT PARTS COLUMN	REM	EMR	A4, B2, B6, C3, D2, D5, 2-B4, 2-D3, 2-D7
8	10250	04/28/2023	UPDATED T-STAT CLIP	AMA	EMR	2-C2, 2-C6
9	10539	09/24/2025	OBSOLETE CL140300-100 & CL150300-100	AJZ	EMR	A6

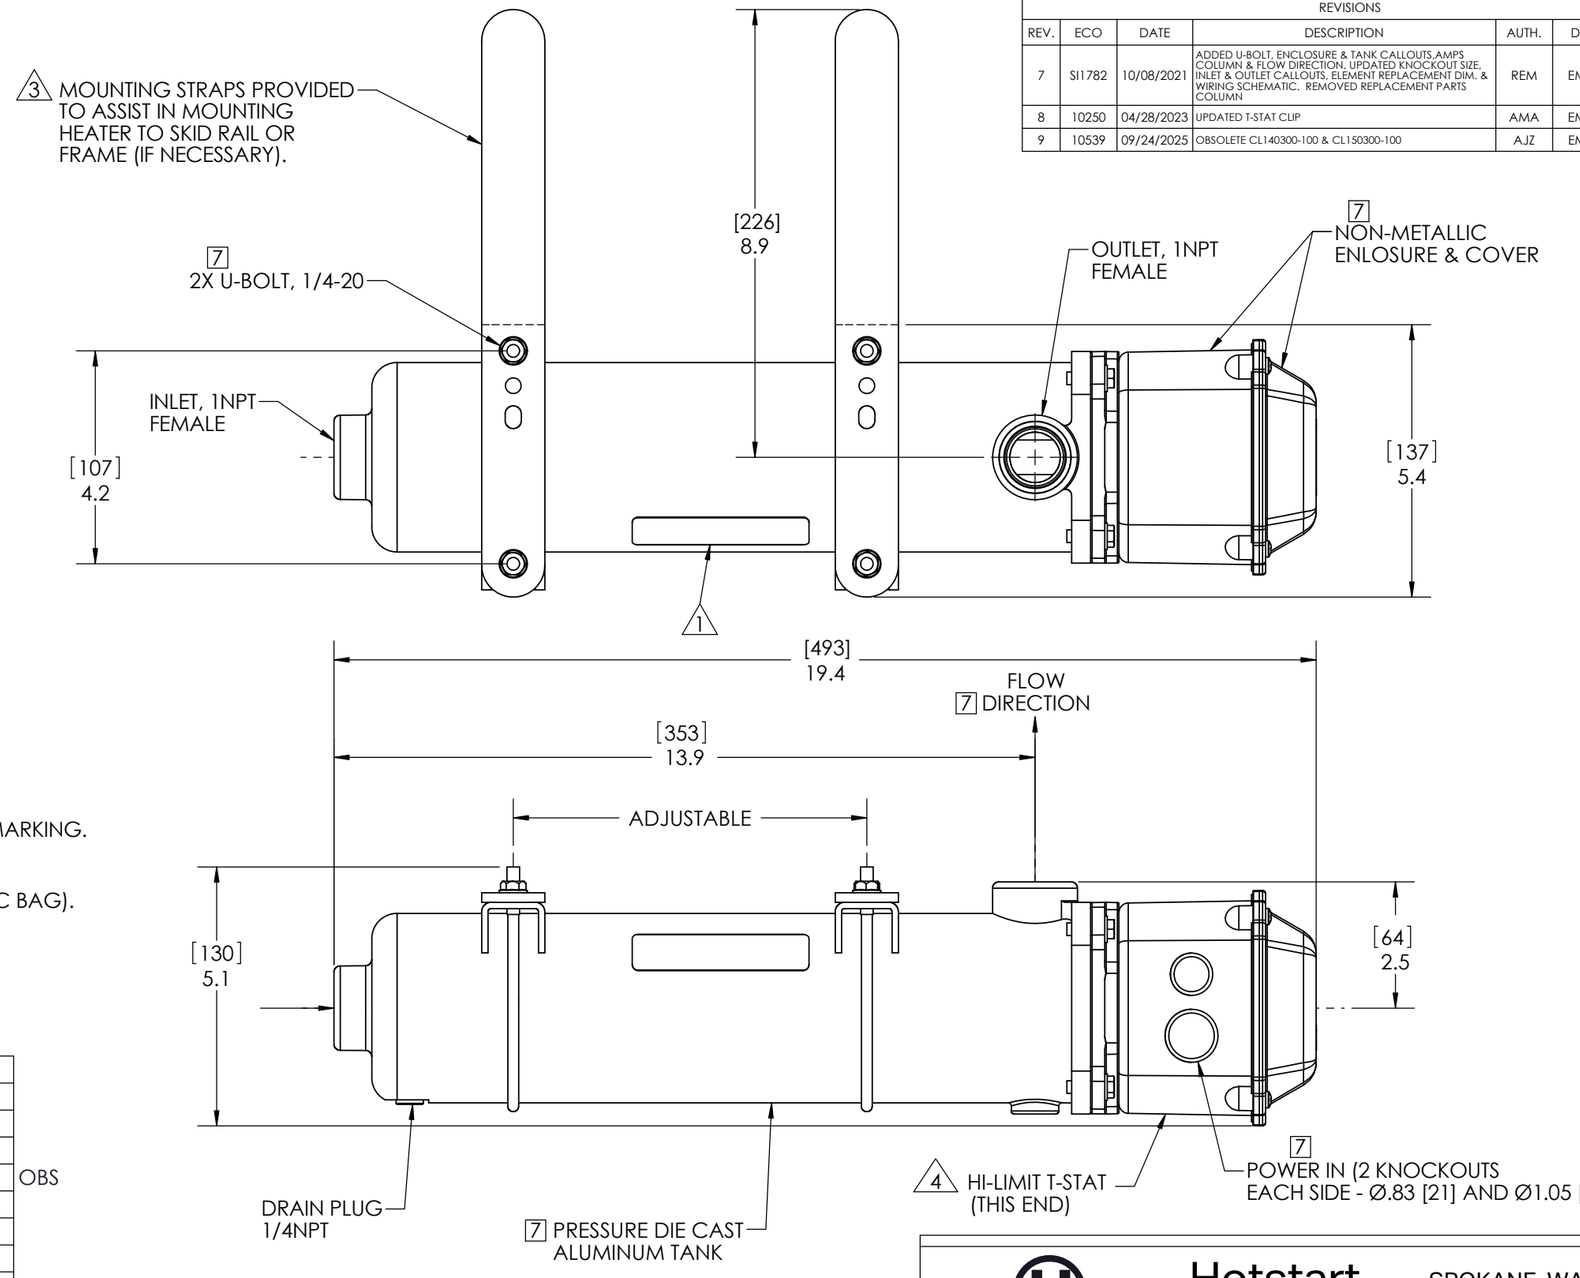

NOTES:

1. LABELED WITH P/N, WATTS, VOLTS, DATE CODE, CE AND UL MARKING.
2. DIMENSIONS ARE FOR REFERENCE ONLY.
3. MOUNTING KIT SHOWN INSTALLED (SHIPPED LOOSE IN PLASTIC BAG).
4. HI-LIMIT SET TO: OPEN AT 205°F ±5°F (96.1°C ±3°C)
   CLOSE AT 165°F ±7°F (73.9°C ±4°C)


PART NUMBER	DESCRIPTION	WIRING CONFIGURATION	7 AMPS	
CL130100-100	CL 3000W 120V 1P W/O TSTAT	PARALLEL	25.0	
CL130800-100	CL 3000W 208V 1P W/O TSTAT	PARALLEL	14.4	
CL130200-100	CL 3000W 240V 1P W/O TSTAT	SERIES	12.5	
CL130700-100	CL 3000W 277V 1P W/O TSTAT	PARALLEL	10.8	
~~CL130300-100~~	~~CL 3000W 380V 1P W/O TSTAT~~	~~PARALLEL~~	~~7.9~~	OBS
CL130400-100	CL 3000W 480V 1P W/O TSTAT	SERIES	6.3	
CL140800-100	CL 4000W 208V 1P W/O TSTAT	PARALLEL	19.2	
CL140200-100	CL 4000W 240V 1P W/O TSTAT	PARALLEL	16.7	
CL140700-100	CL 4000W 277V 1P W/O TSTAT	PARALLEL	14.4	
~~CL140300-100~~	~~CL 4000W 380V 1P W/O TSTAT~~	~~PARALLEL~~	~~10.5~~	OBSOLETE 9
CL140400-100	CL 4000W 480V 1P W/O TSTAT	SERIES	8.3	
CL150800-100	CL 5000W 208V 1P W/O TSTAT	PARALLEL	24.0	
CL150200-100	CL 5000W 240V 1P W/O TSTAT	PARALLEL	20.8	
CL150700-100	CL 5000W 277V 1P W/O TSTAT	PARALLEL	18.1	
~~CL150300-100~~	~~CL 5000W 380V 1P W/O TSTAT~~	~~PARALLEL~~	~~13.2~~	OBSOLETE 9
CL150400-100	CL 5000W 480V 1P W/O TSTAT	SERIES	10.4	

Hotstart. Hotstart SPOKANE, WA.


PROPRIETARY INFORMATION
This drawing and the information shown on it are property of Hotstart, Inc. and are for the sole purpose of doing business with us. Any copying or transmittal to others of this information is strictly prohibited without prior written consent from Hotstart.

TITLE: CL HTR ASM W/O T-STAT


APPROVALS	DATE	UNLESS OTHERWISE SPECIFIED DIMENSIONS ARE IN INCHES [mm]	DWG. NO.	
DRAWN BY CDH	06/18/2002		A-6131-1S	
APPROVED BY JG	06/18/2002	TOLERANCES (Except as noted) .XX ± N/A ANGULAR ± N/A°	SIZE B	ORIGIN CO6714
THIRD ANGLE PROJECTION		.XXX ± N/A DO NOT SCALE DRAWING	SCALE 1:3	SHEET 1 OF 2 REV. 09

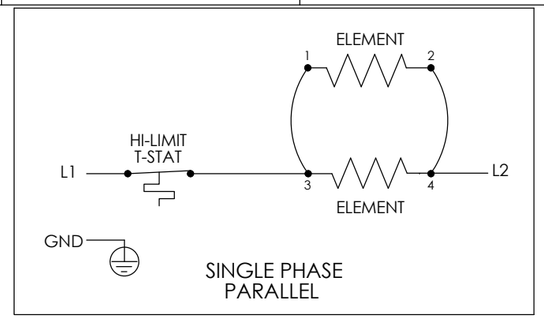


7 WIRING SCHEMATIC

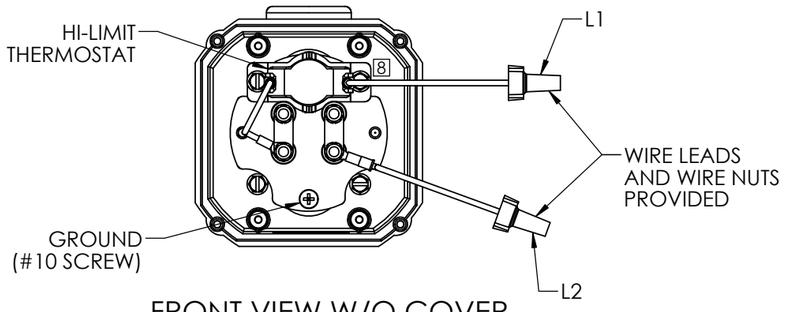


FRONT VIEW W/O COVER
(PARALLEL CONNECTION POINTS)

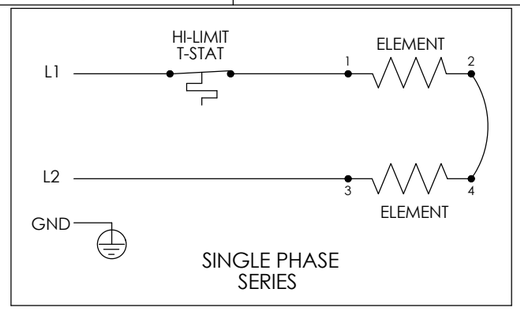

7 WIRING SCHEMATIC

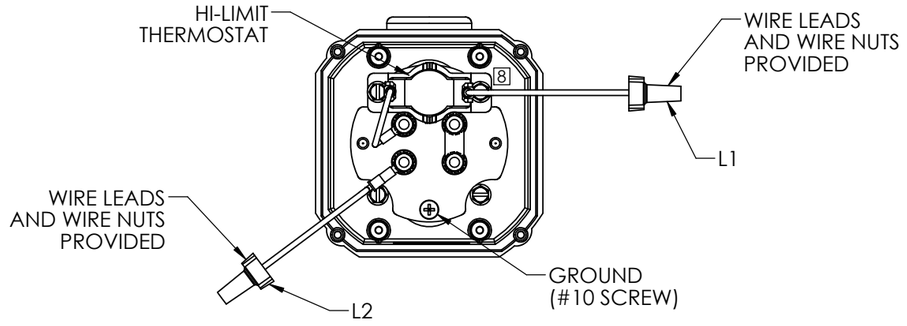

FRONT VIEW W/O COVER
(SERIES CONNECTION POINTS)

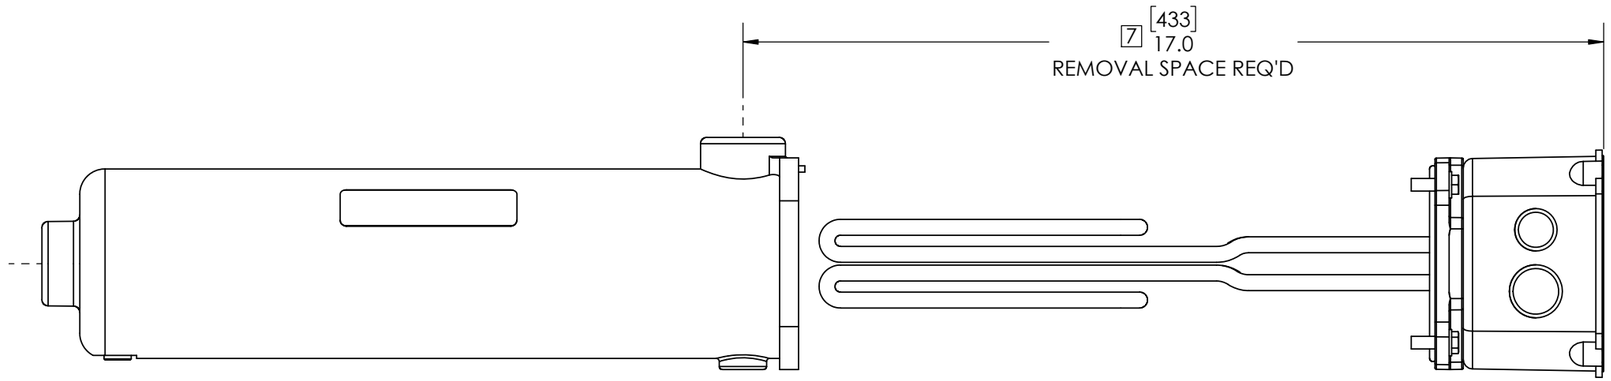

ELEMENT REMOVAL DETAIL

Hotstart. Hotstart SPOKANE, WA.

PROPRIETARY INFORMATION
This drawing and the information shown on it are property of Hotstart, Inc. and are for the sole purpose of doing business with us. Any copying or transmittal to others of this information is strictly prohibited without prior written consent from Hotstart.

TITLE: CL HTR ASM W/O T-STAT

APPROVALS	DATE
DRAWN BY CDH	06/18/2002
APPROVED BY JG	06/18/2002
THIRD ANGLE PROJECTION	

UNLESS OTHERWISE SPECIFIED DIMENSIONS ARE IN INCHES [mm]
TOLERANCES (Except as noted)
.XX ± N/A ANGULAR ± N/A °
.XXX ± N/A
DO NOT SCALE DRAWING

DWG. NO. A-6131-1S
SIZE B
ORIGIN CO6714
SCALE 1:3
SHEET 2 OF 2
REV. 09