


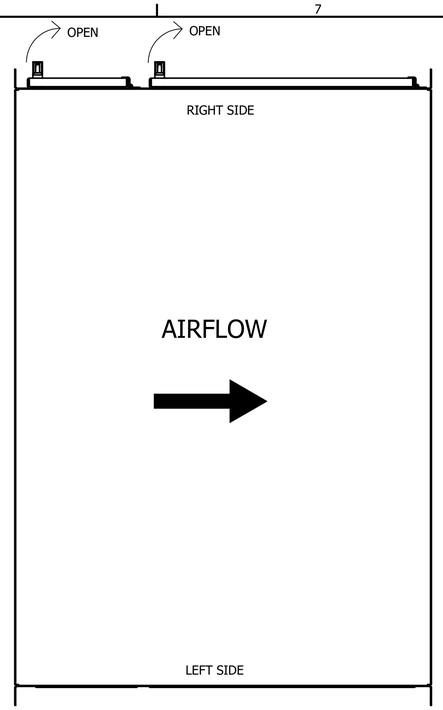


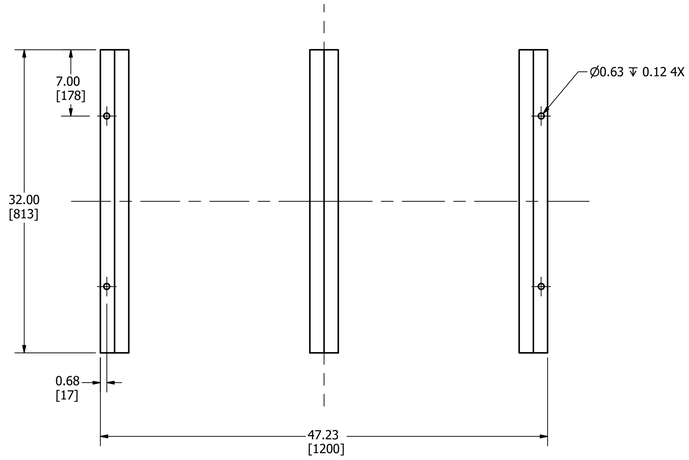

NOTES:
1. DIMENSIONS ARE IN INCHES.
   METRIC EQUIVALENTS IN BRACKETS [ ] ARE IN MILIMETERS.
2. DOORS ARE ON THE RIGHT SIDE.
3. JOINTS ARE SEALED WITH RTV SILICON RUBBER.
4. DOORS ARE SEALED WITH COMPRESSIBLE GASKET.
5. FASTENERS ARE CORROSIVE RESISTANT.
6. FOUR Ø 5/8" [16 mm] MOUNTING HOLES ARE PROVIDED FOR ANCHORING UNIT IN FIELD.
7. THIS UNIT IS BASED ON AN EXTERNAL STATIC PRESSURE OF 0.2 IWG ONLY.
8. A MINIMUM OF 30" [762 mm] DISTANCE IS REQUIRED ON THE LEFT SIDE TO ALLOW PROPER CLEARANCE FOR DOORS.

PURAFIL, INC. REP.: PURATECH

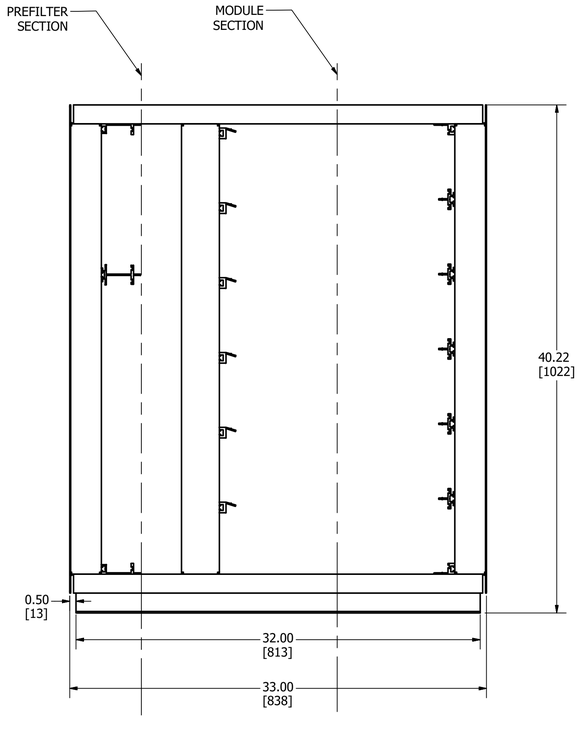

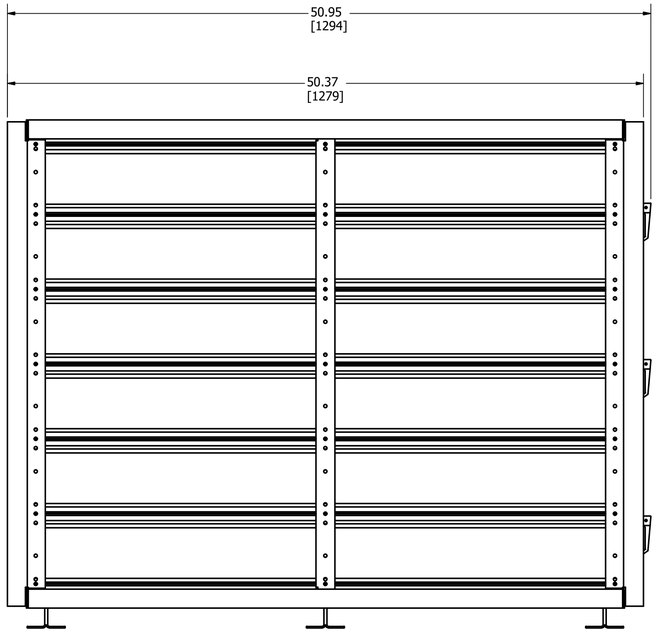



PURAFIL
First...in clean air

JOB/UNIT IDENTIFICATION:

NET CLIMATIS

MODEL NUMBER:	SWPSA 304-33_2P-18M

	MATERIAL:	FINISH:
FRAME:	304 STAINLESS STEEL	MILL
PANELS:	304 STAINLESS STEEL	MILL

DEBIT D'AIR (AIRFLOW):	I△P:	T△P:
3500 ft3/hr [5947 m3/hr]	0.47 iwg [117 Pa]	1.34 iwg [333 Pa]

ELECTRICAL:

VOLTAGE	PHASE	HZ	HP	TYPE
N/A	N/A	N/A	N/A	N/A

PREFILTERS:

QUANTITY	TYPE	SIZE
4	PP-30	24x24x2 [610x610x51]
2	PP-30	12x24x1 [305x610x51]

PURAFIL® AIR PURIFICATION MEDIA(S) IN DIRECTION OF AIRFLOW:

MODULE QUANTITY	MODULE TYPE	MEDIA TYPE	TOTAL MEDIA WEIGHT
12	PK-18	CHLOROSORB ULTRA	288 lbs [131 kg]

FINAL FILTERS:

QUANTITY	TYPE	SIZE
N/A	N/A	N/A

GAGE UNITS:
- ☒ NONE
- ☐ ROOM PRESSURIZATION AND AIRFLOW
- ☐ STATIC PRESSURE DIFFERENTIAL (PREFILTER & FINAL FILTER)

☐ WEATHERPROOFING

- ☐ FOR APPROVAL
- ☐ FOR CONSTRUCTION
- ☐ FOR QUOTE
- ☐ FOR INFORMATION
- ☒ AS BUILT

DATE: 7/5/2019	REV. DATE: 7/8/2019
EMPTY WEIGHT: 346 lbs [157 kg]	APPR. BY: AF
DRAWING NUMBER: 901930	REVISION: A

THIS DRAWING IS THE PROPERTY OF PURAFIL, INC. AND IS NOT TO BE REPRODUCED OR COPIED IN WHOLE OF IN PART. IT IS ONLY TO BE USED FOR THE PROJECT AND SITE SPECIFICALLY IDENTIFIED HEREIN AND IS NOT TO BE USED IN ANY OTHER PROJECT. IT IS TO BE RETURNED UPON REQUEST.

PURAFIL, INC. RESERVES THE RIGHT TO MODIFY DESIGN FOR IMPROVED PRODUCT PERFORMANCE.
PURAFIL ®, PURAFIL II ®, PURASORB ®, CHLOROSORB ®, AND SCOOTER ® SKUNK EMBLEM (REG. US. PAT. & TM OFFICE), PURASTAT ™, HEBA-LOCK ™,
CORROSIVE-AIRE ™, ES ™, PURACARB ™, PM ™ SERIES AND THE DISTINCTIVE SHAPE OF PM ™ MODULES ARE TRADEMARKS OF PURAFIL ™, INC., A U.S.A. CORPORATION.